IF THIS DRAWING IS NOT 34"x36" IT IS A REDUCED PRINT. SCALE ACCORDINGLY

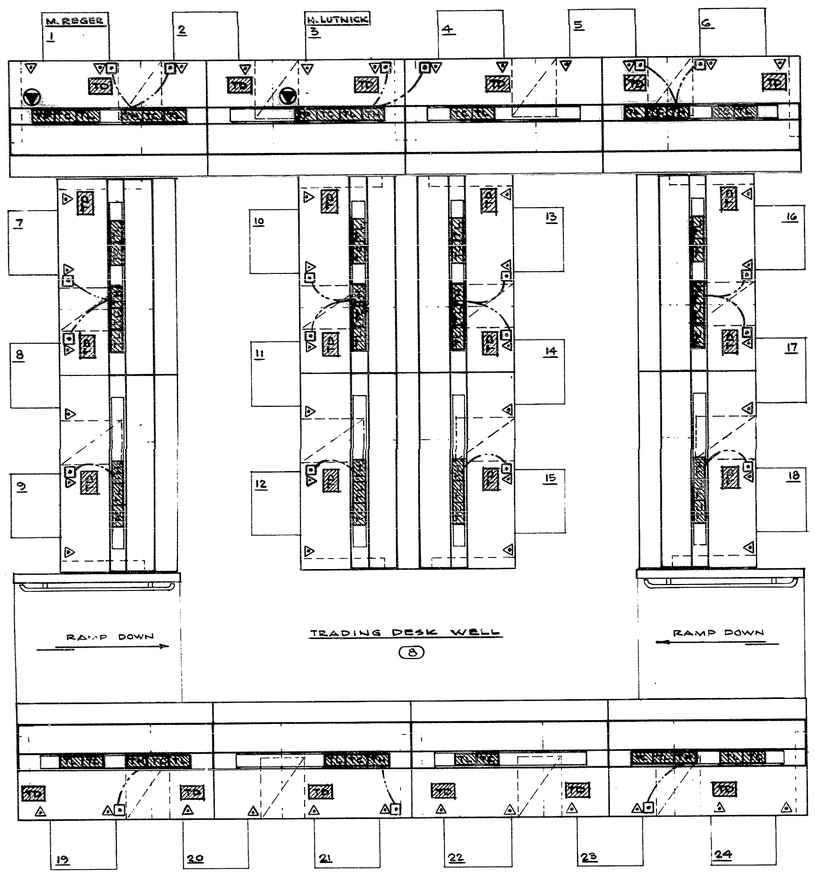

PLAN OF TELEPHONE EQUIPMENT FOR TRADING DESK
@ 1/2"=1'-0"

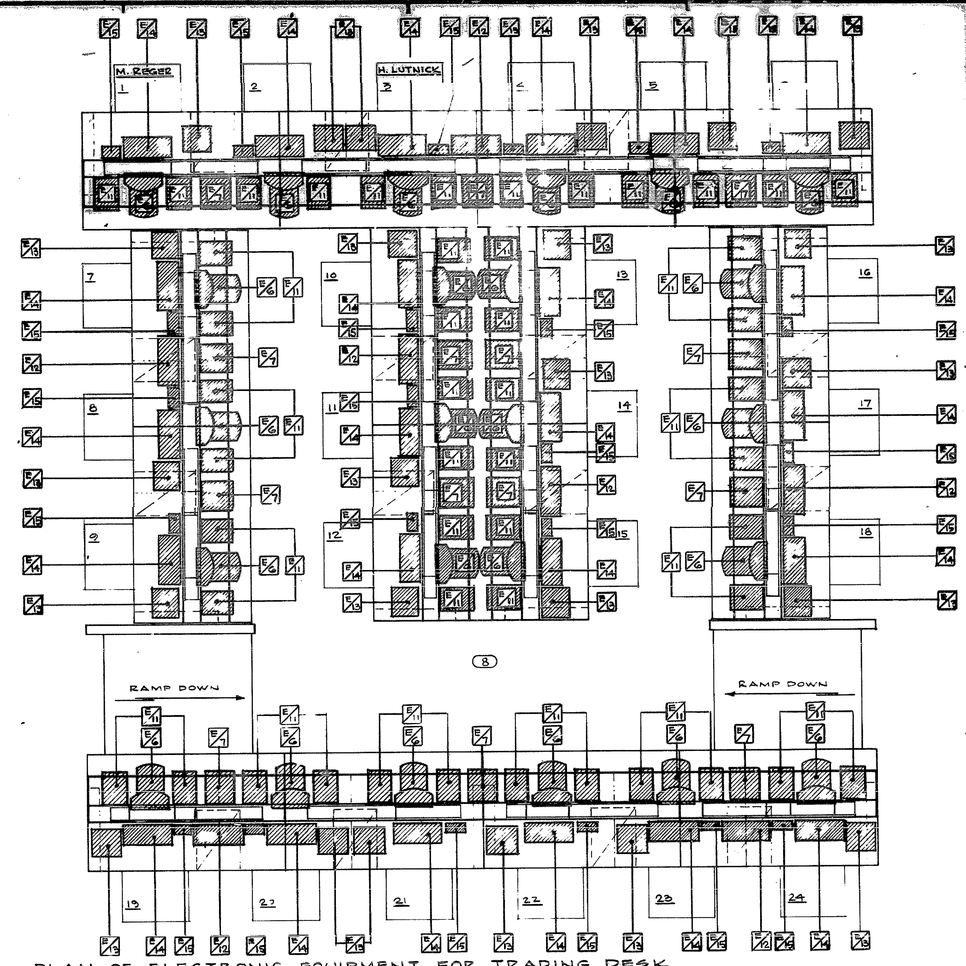

PLAN OF ELECTRONIC EQUIPMENT FOR TRADING DESK
@ 1/2"=1'-0"

LEGEND FOR TELEPHONE EQUIPMENT

SYMBOL	DESCRIPTION	REMARKS
	I.P.C SERIES II COMMAND MODULE W/ATP	INSTALL IN TRADING DESK CONSOLE
	I.P.C SERIES II 40 BUTTON LCD MODULE	INSTALL IN TRADING DESK CONSOLE
	I.P.C. SERIES II 40 BUTTON (4x10) PCD MODULE	INSTALL IN TRADING DESK CONSOLE
	I.P.C. SERIES II HOOT & HOLLER MODULE	INSTALL IN TRADING DESK CONSOLE
	JACK FOR I.P.C. TELEPHONE HANDSET	INSTALL ON UNDERSIDE OF TRADING DESK TOP
	JACK FOR I.P.C. HOOT & HOLLER MICROPHONE	INSTALL ON UNDERSIDE OF TRADING DESK TOP
	6 BUTTON K.V TELEPHONE INSTRUMENT LOCATED ON TRADING DESK TOP	LOCATED ON TRADING DESK SECRETARIAL & PRIVATE OFFICE DESKS
	TELEPHONE SPEED DIALER DASA OR PANASONIC AS DETERMINED BY C.F.S.C.	REQUIRES POWER RECEPTACLE

LEGEND FOR ELECTRONIC EQUIPMENT

SYMBOL	DESCRIPTION MANUFACTURER OR SUPPLIER	MODEL NO	ELECTRICAL REQUIREMENTS VOLTS	AMPS	WATTS OR KVA	REMARKS
E/6	FIXED INCOME MONITOR		120	1.5	90	
E/7	TELERATE /SHARK MONITOR		120	.45	—	
E/11	SPEED MONITOR		120	.45	—	
E/12	TELERATE /SHARK KEYBOARD	—	—	—	—	
E/13	CALCULATOR MONROE	BOND TRADER	115	.5A	—	
E/14	FIXED INCOME KEYBOARD	—	—	—	—	
E/15	SPEED PAGES KEYPAD	—	—	—	—	
E/16						

SYMBOL	DESCRIPTION MANUFACTURER OR SUPPLIER	MODEL NO	ELECTRICAL REQUIREMENTS VOLTS	AMPS	WATTS OR K.V.A	REMARKS

PHASE
P
T.A.A. NO. W91051

STATE OF NEW YORK · JOHN C. WESTRICK · 054052 · LICENSED PROFESSIONAL ENGINEER

JUSTIN P.C. ARCHITECTS
205 LEXINGTON AVE
NEW YORK, NY 10016
TEL (212) 689 5550

JOHN C. WESTRICK & ASSOCIATES
CONSULTING ENGINEERS
2110 MAPLE AVE. SOUTH PLAINFIELD, N.J.
07080 201 561-4170

DATE	ISSUED TO	PR.	T.R.
3/22/91	PORT AUTHORITY FOR APPROVAL	10	1
3/22/91	CFSC FOR RECORD CONTRACTORS FOR BIDDING	5 4	 4
4/19/91	CFSC	1	1
5-3-91	P.A. FOR APPROVAL	10	–
5/30/91	P.A. FOR APPROVAL	6	1
6-7-91	CFSC	1	–
6-19-91	PORT AUTHORITY	10	1
10-21-91	P.A. "AS BUILT DRAWING"	–	1

NOTE:
THIS DRAWING HAS NOT BEEN REVISED TO REFLECT THE AS BUILT CONDITIONS OF THE TRADING DESK, TELEPHONE & ELECTRONIC EQUIPMENT.

NO.	DATE	REVISION	BY
1	8-6-91	ADDED NOTE RE: AS BUILT CONDITIONS	JFP

CANTOR, FITZGERALD SECURITIES CORP.
105th FLOOR
ONE WORLD TRADE CENTER, NEW YORK N.Y.

PROPOSED NEW TRADING ROOM FOR INVESTMENT STRATEGIES
TELEPHONE MODULES, ELECTRONIC EQUIPT. & SWITCH LOCATION PLAN FOR TRADING DESKS

NORTH

PROJECT NO.	706
SCALE	1/2"=1'-0"
DRAWN BY	JFP
CHECKED BY	JFP
DATE	MARCH 20, 1991

DRAWING NO.
105P 9

DRAWING NUMBER 593.013 91051

A-105 CANTOR FITZGERALD 105 P-9

DRAWING NUMBER

DRAWING NUMBER